

Z:\10_PERSONNEL\Baranov\Work\35966 ST Logistics\REV\738966 ST-22-2018.dwg
10/13/17 14:02:34

SITE SAFETY LOGISTICS PLAN FOR WEST 66TH STREET

(EXCAVATION AND FOUNDATION PHASES)

36 WEST 66TH STREET, NEW YORK, NY 10023
BLOCK 1118, LOT 14, 45, 46,47 & 48. ZONING MAP 8d
COMMUNITY BOARD: 107

BIN# 1028168
HEIGHT: 775' TALL (41 STORY) CONCRETE STRUCTURE
RESIDENTIAL BUILDING

D.O.B. #121-190-200




200 PARK AVENUE
NEW YORK, NY 10166

2	01/22/2018	Building Information Changed
1	01/22/2018	Lot Added
NO.	DATE	REVISION

PROJECT
WEST 66TH STREET

A NEW BUILDING AT
36 West 66th Street

Title Block

SEAL & SIGNATURE	DATE: 10/13/17
	PROJECT No.:
	DRAWING BY:
	CHECKED BY:
	DWG No.
	SSP-001.01
SCALE:	CADD FILE No.: PAGE No.: of

PREPARED BY:
LEND LEASE (US) CONSTRUCTION LMB, INC.
BIM / LOGISTICS DEPARTMENT
TEL: 212-592-6700
E-MAIL: VLADIMIR.BARANOV@LENDLEASE.COM

Z:\16_PERSONNEL\Bureau\WWS\35068 ST. LORENTZ\REVIT\16068 ET-22 2016.rvt
16/04/2016

EMERGENCY PHONE NUMBERS

MEDICAL EMERGENCY
NYU MEDICAL CENTER
400 EAST 34TH STREET
212.263.6034
EMERGENCY: 911

FIRE DEPARTMENT EMERGENCY
ENGINE 40 LADDER 35
131 AMSTERDAM AVE.
DISPATCH: 911

POLICE DEPARTMENT
MIDTOWN NORTH PRECINCT
306 WEST 54th STREET
TEL: (212) 477-7411

U.S. DEPARTMENT OF LABOR (OSHA)
345 HUDSON STREET
TEL: (212) 352-6000

NYC. DEPT. OF BUILDINGS
280 BROADWAY
TEL: (212) 566-5000

SITE SAFETY NOTIFICATION
TEL: (212) 566-3199

COMMISSIONER RICH CHANDLER
280 BROADWAY
TEL: (212) 566-5000

CHIEF INSPECTOR (B.E.S.T. SQUAD)
PHIL KRIKORIAN
2 LAFAYETTE STREET, 12th FLOOR
TEL: (212) 602-0406

MAYOR'S TRAFFIC COMMISSION
8:30 A.M. TO 4 P.M.
TEL: (718) 802-3713

CONTRACTOR:
LEND LEASE (US) CONSTRUCTION LMB
200 PARK AVENUE, 9TH FLOOR
NEW YORK, NY 10166
CONTACT PERSON: TBD
212.592.6700
TRACKING #: 016836-F

PROJECT EXECUTIVE:
ANTHONY MANNION
212.592.6700

SITE SAFETY MANAGER:
NAME: NICOLAS DELLI VENERI
TEL: 212.592.6700
LICENCE #M000221

CONSTRUCTION SUPERINTENDENT:
NAME: NICOLAS DELLI VENERI
TEL: 212.592.6700
LICENCE #M000221

CONCRETE SAFETY MANAGER:
NAME: JOSEPH S ALBANESE
718.991.5100
LICENCE #000625-GC

CONSTRUCTION FIRE SAFETY MANAGER:
CHRISTOPHER BURCZYK
212.592.6700
LICENCE# 85893568
EXP. DATE 5/23/2014

OWNER OF PROPERTIES:
EXTEL DEVELOPMENT CORP.
805 THIRD AVENUE
NEW YORK, NY 10022
CONTACT PERSON: DAVID ROTHSTEIN
212.421.5333

ARTICLE 110
SITE SAFETY PLAN
*§28-110.1 SITE SAFETY PLAN. WHERE A SITE SAFETY PLAN IS REQUIRED BY CHAPTER 33 OF THE NEW YORK CITY BUILDING CODE, SUCH PLAN SHALL INCLUDE THE FOLLOWING:
1. LOCATION OF ALL CONSTRUCTION FENCES AROUND WORK SITE;
2. LOCATION OF ALL GATES IN CONSTRUCTION FENCES;
3. LOCATION OF STANDARD GUARDRAILS AROUND EXCAVATIONS, WHERE REQUIRED;
4. HORIZONTAL AND VERTICAL NETTING PROGRAM, INCLUDING DETAILS OF THE INITIAL INSTALLATION, SCHEDULE OF HORIZONTAL JUMPS AND VERTICAL INSTALLATIONS, AND DESIGNATED CRANE AND DERRICK LIFTING AREAS WHERE HORIZONTAL NETTING IS OMITTED. THE PROGRAM SHALL INCLUDE AS AN ATTACHMENT ANY DEPARTMENT APPROVAL OBTAINED REGARDING REQUIRED SAFETY NETTING DURING CONSTRUCTION OR DEMOLITION OPERATIONS; THE REVISED SITE SAFETY PLAN SHALL BE APPROVED;
5. LOCATION OF ALL SIDEWALK SHEDS, INCLUDING APPROPRIATE DEPARTMENT APPLICATION NUMBERS AND DEPARTMENT OF TRANSPORTATION PERMIT NUMBERS AND EXPIRATION DATES;
6. LOCATION OF ALL TEMPORARY WALKWAYS, INCLUDING APPROPRIATE DEPARTMENT APPLICATION NUMBERS AND DEPARTMENT OF TRANSPORTATION PERMIT NUMBER AND EXPIRATION DATES;
7. LOCATION OF FOOT BRIDGES AND MOTOR VEHICLE RAMPS, INCLUDING APPROPRIATE DEPARTMENT APPLICATION NUMBERS AND DEPARTMENT OF TRANSPORTATION PERMIT NUMBER AND EXPIRATION DATES;
8. PROTECTION OF SITE OF EXCAVATION, WHEN REQUIRED, INCLUDING APPROPRIATE DEPARTMENT APPLICATION NUMBERS AND DEPARTMENT OF TRANSPORTATION PERMIT NUMBER AND EXPIRATION DATES;
9. LOCATION OF ALL STREET AND SIDEWALK CLOSING(S), INCLUDING APPROPRIATE DEPARTMENT APPLICATION NUMBERS AND DEPARTMENT OF TRANSPORTATION PERMIT NUMBER AND EXPIRATION DATES;
10. APPROXIMATE LOCATION OF MATERIAL AND PERSONNEL HOIST(S) AND LOADING AREAS, INCLUDING APPROPRIATE DEPARTMENT APPLICATION NUMBERS AND DEPARTMENT OF TRANSPORTATION PERMIT NUMBER AND EXPIRATION DATES;
11. APPROXIMATE LOCATION OF ALL CRANE AND DERRICK LOADING AREAS;
12. LOCATION OF ALL SURROUNDING BUILDINGS, INDICATING OCCUPANCY, HEIGHT AND TYPE OF ANY REQUIRED ROOF PROTECTION;
13. LOCATION OF ALL STANDPIPE SYSTEM AND SIAMESE HOSE CONNECTION;
14. LOCATION OF ALL TEMPORARY ELEVATORS FOR FIRE DEPARTMENT USE WHEN BUILDING IS ABOVE 75 FEET (22 860 MM) IN HEIGHT;
15. LOCATION OF ALL EXTERIOR CONTRACTOR'S SHEDS;
16. ALL REQUIRED SAFETY NETTING AND SCAFFOLDING;
17. WIDTHS OF ALL SIDEWALKS AND ROADWAYS; ALL TRAFFIC INFORMATION; ALL EXITS FROM JOB SITE;
18. A COPY OF THE PROPOSED SITE SAFETY MANAGER OR SITE SAFETY COORDINATORS CERTIFICATE, AS APPLICABLE, INCLUDING THE CERTIFICATE FOR ANY ALTERNATE SITE SAFETY MANAGER OR SITE SAFETY COORDINATOR;
19. SUCH FEATURES REQUIRING SPECIAL SEQUENCING IN ORDER TO MAINTAIN SAFE CONDITIONS WITH A WRITTEN DESCRIPTION OF THOSE SEQUENCES;
20. THE SITE SAFETY PLAN SHALL INCLUDE A STATEMENT THAT PRIOR TO PERFORMING ANY WORK ON THE PROJECT ALL WORKERS SHALL HAVE SUCCESSFULLY COMPLETED, WITHIN THE PREVIOUS FIVE CALENDAR YEARS, A TEN HOUR COURSE APPROVED BY THE UNITED STATES DEPARTMENT OF LABOR OCCUPATIONAL SAFETY AND HEALTH ADMINISTRATION IN CONSTRUCTION INDUSTRY SAFETY AND HEALTH, OR BY THE COMMISSIONER COVERING SUBSTANTIALLY THE SAME MATERIAL. SUCCESSFUL COMPLETION OF SUCH TRAINING COURSE SHALL BE EVIDENCED BY (A) PRESENTATION OF BONA FIDE COURSE COMPLETION CARD, (B) COPY OF SUCH CARD, (C) A TRAINING ROASTER, ATTENDANCE RECORD OR OTHER DOCUMENTATION FROM THE CERTIFIED TRAINER PENDING THE ISSUANCE OF SUCH CARD OR (D) OTHER VALID PROOF WHICH MAY BE APPROVED BY THE COMMISSIONER. SUCH EVIDENCE SHALL BE READILY AVAILABLE TO THE COMMISSIONER UPON REQUEST; AND
21. A STATEMENT THAT ALL WORKERS EMPLOYED ON THE SITE WILL RECEIVE A SITE-SPECIFIC SAFETY ORIENTATION PROGRAM. THIS PROGRAM SHALL INCLUDE A REVIEW OF ANY HAZARDOUS ACTIVITIES OF THE JOB THAT ARE RELEVANT TO THE TASKS AND ACTIVITIES TO BE PERFORMED. ALL WORKERS MUST ATTEND SUCH A PROGRAM NO LATER THAN SEVEN DAYS AFTER COMMENCING THEIR EMPLOYMENT.
*SECTION 28-110.1 (#18 - #19) WAS AMENDED BY AND (#20 - #21) WAS ADDED BY: LOCAL LAW 41 OF 2008 - UPDATED #10. THIS LAW HAS AN EFFECTIVE DATE OF DECEMBER 02, 2008.
§28-110.2 PHASED SITE SAFETY PLANS. MULTIPLE LAYOUTS OF THE SITE SAFETY FEATURES ENUMERATED IN SECTION 28-110.1 MAY BE SUBMITTED AT ANY TIME DURING CONSTRUCTION OPERATIONS TO SHOW PHASED SITE SAFETY DESIGNS CONSISTENT WITH THE PHASE OF ANTICIPATED WORK.


3301.9.2 CONSTRUCTION SITES.
AT HEIGHT OF NO MORE THAN 12 FEET ABOVE THE GROUND ON EACH PERIMETER OF CONSTRUCTION SITE FRONTING A PUBLIC THOROUGHFARE, A SIGN SHALL BE ERECTED CONTAINING FOLLOWING INFORMATION:
1. THE NAME, ADDRESS AND TELEPHONE NUMBER OF THE OWNER OF THE PROPERTY;
2. THE NAME, ADDRESS AND TELEPHONE NUMBER OF THE GENERAL CONTRACTOR; AND
3. THE PHONE NUMBER FOR REPORTING COMPLAINTS;
IN ADDITION, COPIES OF ALL PERMITS SHALL BE DISPLAYED IN A CONSPICUOUS LOCATION READILY VISIBLE BY THE PUBLIC.

WATCHMEN CALCULATIONS
1 WATCHMAN REQUIRED PER 40,000 S.F. (BUILDING FOOTPRINT)
BUILDING FOOTPRINT = 22,580 S.F.
1 WATCHMEN REQUIRED.

INDEX OF DRAWINGS

SHEET	NAME	APPROVAL DATE	AMENDED DATE
SSP-001.01	Title Block	10/24/2016	
SSP-002.03	General Information	10/24/2016	8/16/2017
SSP-210.02	Excavation Phase 1	10/24/2016	2/16/2017
SSP-220.03	Excavation Phase 2	10/24/2016	6/14/2017
SSP-240.00	Excavation Phase 3.		
SSP-270.00	Excavation and Foundation, Phase 1		
SSP-273.00	Excavation and Foundation, Phase 2		
SSP-340.03	Foundation Plan, Option 1	10/24/2016	6/14/2017
SSP-311.00	Foundation Plan, Option 2	10/24/2016	2/16/2017
SSP-320.00	Foundation Plan, Option 3	8/16/2017	
SSP-335.00	Foundation Phase		
SSP-410.00	Superstructure Below 75' Logistics, Ground Floor	2/16/2017	
SSP-420.00	Superstructure Above 75' Logistics, Ground Floor	2/16/2017	
SSP-425.00	Superstructure Logistics, Top Floor (Typical)	2/16/2017	
SSP-600.00	Safety Detail	10/24/2016	
SSP-601.00	Safety Detail	2/16/2017	

KEY PLAN

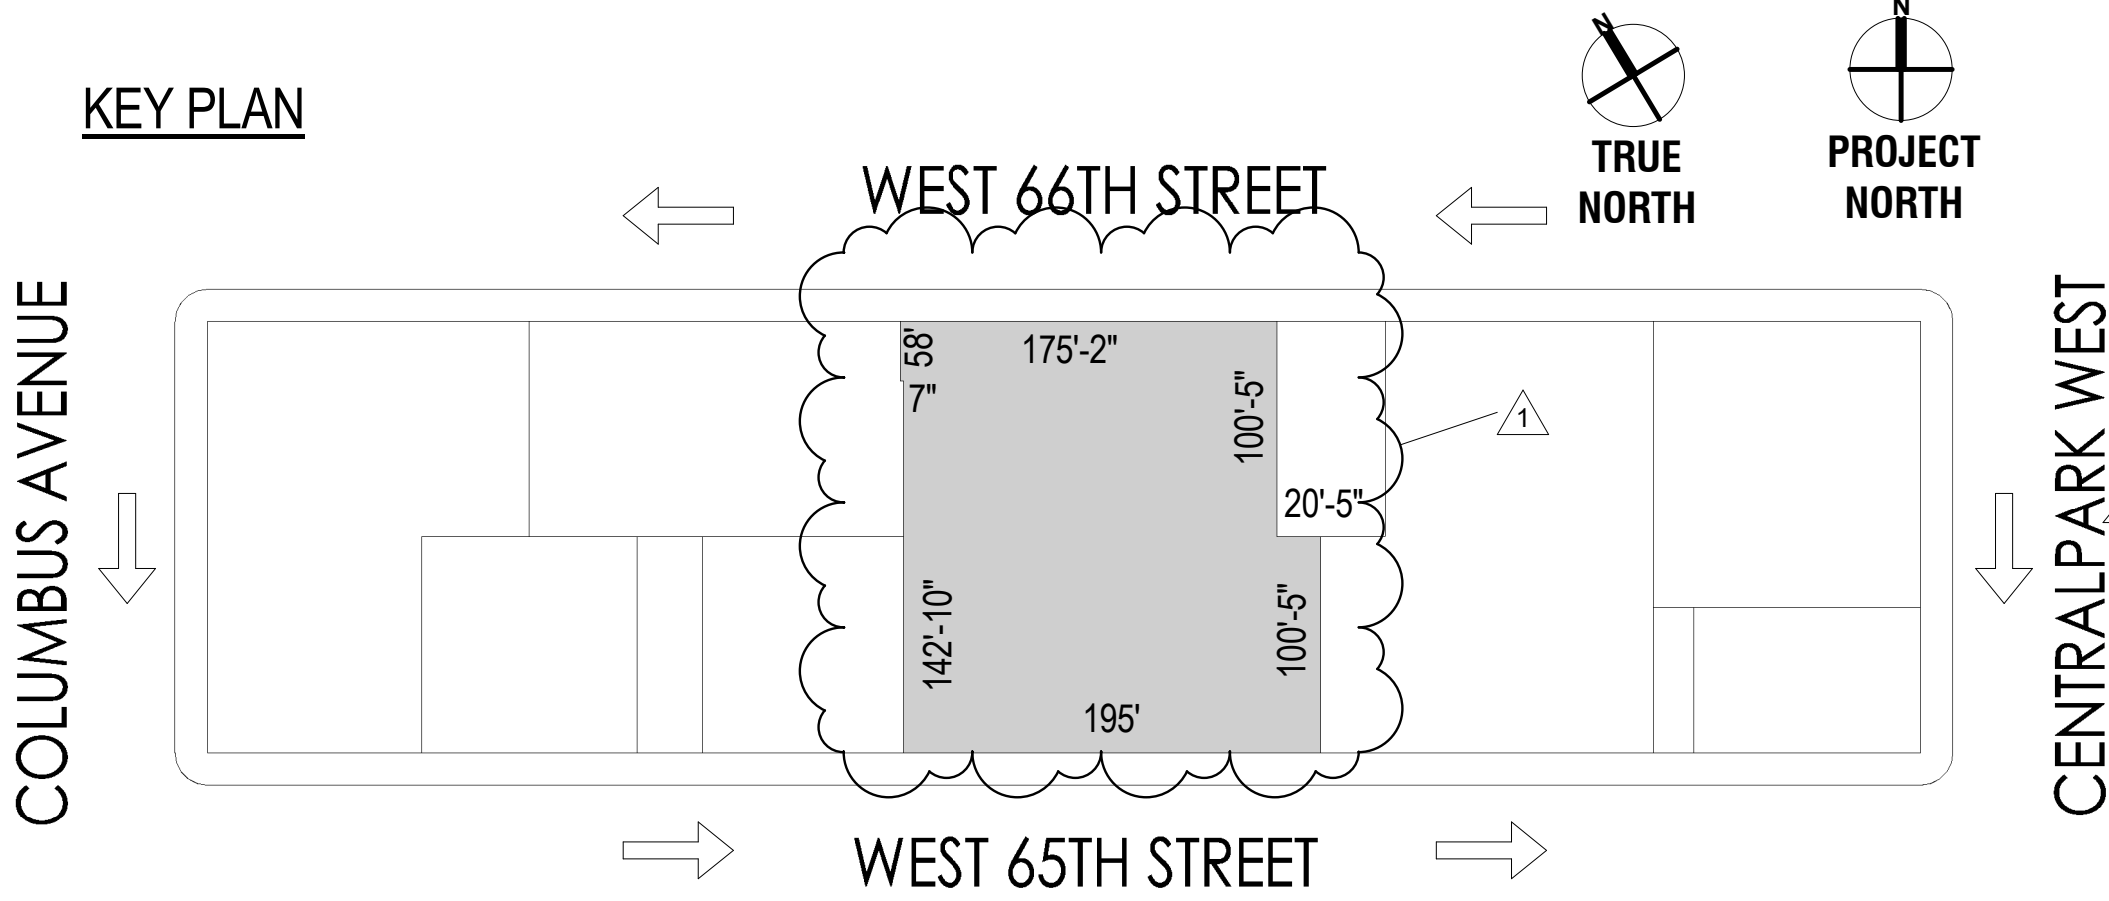

PERMITS & APPROVALS

Permit Number	Description	Expires
DOB Permits		
121190200-01-NB	New Building Lot Merger Application Pending	10/1/2018
121190200-01-FO	New Building - Foundation/Earthwork New Building	10/1/2018
121190200-01-FO-EA	New Building - Earthwork New Building	10/1/2018
140693239-01-EQ-SF	Alteration Type 3 - Construction Equipment - Scaffold installation of pipe scaffold as per plans. Work shall comply with 2014 Building Code Chapter 33. No change in use, egress or occupancy.	9/21/2018
140659428-01-EQ-OT	Alteration Type 2 - Construction Equipment - Other interior alteration as per plans filed herewith. No change in use, occupancy, or egress.	7/14/2018
121190200-01-EQ-FN	New Building - Construction Equipment - Fence New Building	10/18/2018
DOT Permits		
M02-2017354-G89	0201 - Place Material on Street	3/29/2018
M02-2017354-G90	0202 - Crossing Sidewalk	3/29/2018
M02-2017354-G91	0205 - Place Construction Office Trailer on Street	3/29/2018
M02-2017354-G92	0208 - Temporary Pedestrian Walkway	3/29/2018
M02-2017354-G93	0211 - Occupancy of Roadway as Stipulated	3/29/2018
M02-2017354-G94	0215 - Occupancy of Sidewalk as Stipulated	3/29/2018
M02-2017354-G95	0221 - Temporary Construction Signs/Markings	3/29/2018
M02-2017354-G96	Jersey barriers	3/29/2018
M02-2017354-G97	Maintain fence	3/29/2018
M02-2017354-G98	Portable Toilets (x4)	3/29/2018
M02-2017354-G99	Sidewinder pump	3/29/2018
M02-2017354-H00	FDNY storage boxes	3/29/2018
M02-2017354-H01	Gang boxes	3/29/2018
FDNY Permits		
F 0009049	Account #37011707	10/18/2018

NOTES:

NOTIFICATIONS
DEMOLITION NOTIFICATION
DEMOLITION SQUAD MUST BE CALLED 24 HOURS BEFORE START OF DEMOLITION WORK TO OBTAIN A CONFIRMATION NUMBER. (212.227.4416)
NOTIFICATION OF ADJOINING PROPERTY OWNERS.
ADJOINING PROPERTY OWNERS SHALL BE NOTIFIED OF UPCOMING DEMOLITION OPERATIONS IN WRITING NOT LESS THAN 10 DAYS PRIOR TO THE SCHEDULED STARTING DATE OF THE DEMOLITION. THE WRITTEN NOTICE SHALL PROVIDE A DESCRIPTION OF THE WORK TO BE PERFORMED, THE TIMEFRAME AND SCHEDULE, AND CONTACT INFORMATION OF THE PERSON CAUSING THE DEMOLITION AND OF THE DEPARTMENT.
EXCAVATION NOTIFICATION
EXCAVATION SQUAD MUST BE CALLED 24 HOURS BEFORE START OF EXCAVATION WORK TO OBTAIN A CONFIRMATION NUMBER. (212.227.4416)
NOTIFICATION OF ADJOINING PROPERTY OWNERS.
WHEN AN EXCAVATION TO A DEPTH OF 5' TO 10' IS TO BE MADE WITHIN 10' OF AN ADJACENT BUILDING, OR WHEN ANY EXCAVATION OVER 10' IS TO BE MADE ANYWHERE ON THE SITE, THE PERSON CAUSING AN EXCAVATION TO BE MADE SHALL PROVIDE WRITTEN NOTICE TO THE OWNERS OF THE ADJACENT BUILDING OR BUILDINGS NOT LESS THAN 10 DAYS PRIOR TO THE SCHEDULED STARTING DATE OF EXCAVATION.
ALL OTHER WORK NOTIFICATION
A COPY OF THE PW2 TOGETHER WITH A LETTER WRITTEN ON COMPANY LETTER HEAD MUST BE SENT TO THE B.E.S.T. SQUAD, ATTENTION B.E.S.T. CHIEF INSPECTOR VIA MESSENGER OR EMAIL AT BEST@Buildings.NYC.gov 24 HOURS PRIOR TO THE COMMENCEMENT OF WORK
NOTIFICATION TO REQUEST START WORK FACADES ONLY
- FOR ALL SUSPENDED SCAFFOLDING NOTIFICATIONS MUST BE CALLED IN TO THE CALL CENTER 24 HOURS BEFORE START OF WORK AND AT TIME OF REMOVAL 212-393-2550;
- 24 HOURS BEFORE START OF WORK, ON COMPANY LETTER HEAD, SEND A LETTER VIA EMAIL OF NOTIFICATION TO THE SCAFFOLD SAFETY TEAM AND A COPY OF THE PW2. SSTWSRemoval@buildings.nyc.gov
CLOSEOUT
- PARTIAL REMOVING SIDEWALK SHEDS REQUIRES AN AMENDED PLAN, NOTIFICATION TO THE B.E.S.T. SQUAD AND AN INSPECTION BY THE B.E.S.T. SQUAD.
- PERMANENTLY REMOVING SIDEWALK SHEDS REQUIRES NOTIFICATION TO THE B.E.S.T. SQUAD AND AN INSPECTION BY B.E.S.T. SQUAD.
- REMOVAL OF SITE SAFETY IT REQUIRES NOTIFICATION TO THE B.E.S.T. SQUAD AND AN INSPECTION BY THE B.E.S.T. SQUAD.
CALL (212)-393-2476
SITE SAFETY MANAGER REMOVAL
REQUIRES FULL ENCLOSURE OF BUILDING AND DOB CLASSIFYING THE PROJECT AS NON SITE SAFETY PROJECT.
INCIDENTS NOTIFICATION:
AS PER 3310.2(7) OF THE NEW YORK CITY BUILDING CODE, SITE SAFETY COORDINATORS, DESIGNATED PERSONS AND SITE SAFETY MANAGERS MUST IMMEDIATELY REPORT INCIDENTS TO THE BUILDING DEPARTMENT. A CALL MUST BE MADE TO THE CALL CENTER **212-566-3199**. THE FOLLOWING INCIDENTS MUST BE REPORTED.
- ANY FATALITY
- ANY INJURY TO A MEMBER OF THE PUBLIC
- ANY WORKER INJURY REQUIRING EMS TREATMENT OR HOSPITALIZATION
- ANY WORKER FALL (EXCEPT FOR SLIPS AND TRIPS)
- ANY PROPERTY DAMAGE - PUBLIC OR PRIVATE
- ANY MATERIAL FAILURE OR COLLAPSE
- ANY FALLING MATERIAL OR DEBRIS
MISCELLANEOUS
ALL HAZARDOUS CONDITIONS WILL BE IMMEDIATELY REPORTED TO THE B.E.S.T. SQUAD AT **212-566-3199**

NOTE:
*THE WORK WILL COMPLY WITH ALL APPLICABLE SECTION OF CHAPTER 33 OF NYC BUILDING CODE AND ALL OSHA 1926 STANDARDS FOR CONSTRUCTION;
*ALL BARRIERS LOCATED IN THE STREET MUST BE INSTALLED AS PER DOT REGULATIONS AN MANUFACTURE SPECIFICATIONS;
*NO CRANE MAY OPERATE UNTIL THE SITE SAFETY PLAN MATCHES THE APPROVED ON, OIW "LIMITED USE" OR MASTER RIGGERS OPERATIONS;
STATEMENT
*ALL WORKERS EMPLOYED ON THE SITE WILL RECEIVE A SITE-SPECIFIC SAFETY ORIENTATION PROGRAM. THIS PROGRAM SHALL INCLUDE A REVIEW OF ANY HAZARDOUS ACTIVITIES OF THE JOB THAT ARE RELEVANT TO THE TASKS AND ACTIVITIES TO BE PERFORMED. ALL WORKERS MUST ATTEND SUCH A PROGRAM NO LATER THAN SEVEN DAYS AFTER COMMENCING THEIR EMPLOYMENT.

MATERIAL HANDLING PLAN - SUPERSTRUCTURE PHASE
1. BEFORE A LOADED BOOM IS SWING OVER THE HOIST, THE HOIST CAGE(S) WILL BE BROUGHT DOWN TO ITS LOWEST LEVEL, AND EVERYONE MUST EXIT THE HOIST
2. AT NO TIME WILL ANY CONSTRUCTION EQUIPMENT COME WITHIN TWO FEET SIX INCHES (30") TO ANY MOVING PART OF THE HOIST. (EXCLUDING SETUP AND JUMPING OF THE HOIST).
3. IF AT ANY TIME ANY CONSTRUCTION EQUIPMENT COMES WITHIN 15' OF THE HOIST, THE FOLLOWING PROTOCOL WILL BE FOLLOWED:
- AT LEAST ONE SIGNAL PERSON WILL BE SPECIFICALLY ASSIGN TO THE OPERATION THAT IS WITHIN 15' OF THE HOIST.
- THE HOIST OPERATOR ALL SIGNAL PERSONNEL AND LEND LEASE SUPERINTENDENT WILL BE IN RADIO COMMUNICATION WITH EACH OTHER.
4. IF A LOADED BOOM IS SWING OVER THE HOIST, SEE ITEM 1 ON THIS LIST. WHEN THE LOAD IS OFF THE BOOM, THE SIGNAL PERSON SHALL LET THE HOIST OPERATOR AND LEND LEASE SUPERINTENDENT KNOW THAT THEY CAN PROCEED AS NORMAL. LEND LEASE SUPERINTENDENT TO ISSUE FINAL DIRECTION TO RESUME HOIST OPERATION.
5. THERE WILL NOT BE ANY CONSTRUCTION EQUIPMENT PERMANENTLY LOCATED WITHIN 15' OF THE HOIST.

LEGEND

SEWER MANHOLE		SIDEWALK BRIDGE
ELECTRIC MANHOLE		SIDEWALK BRIDGE - HIGH
TELEPHONE MANHOLE		
WATER MANHOLE		LOADING DOCK
GAS VALVE		
WATER VALVE		ROOF PROTECTION
STORM DRAIN		
LIGHT POLE		ATRIUM / SKYLIGHT PROTECTION
FIRE HYDRANT		
ADJACENT BUILDING EGRESS LOCATION		RESTRICTED ACCESS ZONE
AUTOMOTIVE TRAFFIC FLOW		
PEDESTRIAN TRAFFIC FLOW		FLOOR OPENING PROTECTION
SIGN POLE		
SIAMESE CONNECTION / STANDPIPE CONNECTION		
RED LIGHT AT FIRE DEPARTMENT CONNECTION	-X-X-	PLYWOOD CONSTRUCTION FENCE WITH 4' CANTILEVER
TEMPORARY LADDER	-XX-XX-	PLYWOOD CONSTRUCTION FENCE ON TOP OF BARRIER WITH 4' CANTILEVER
STAIR TOWER	-cf-cf-	PLYWOOD CONSTRUCTION FENCE WITHOUT CANTILEVER
EXISTING TREE	-lf-lf-	PLYWOOD CONSTRUCTION FENCE ON TOP OF BARRIER WITHOUT CANTILEVER
	-o-o-	WOOD GUARDRAIL
WOODEN MOVEABLE BARRIER	-++-++-	FULL HEIGHT FENCE UNDER OVERHEAD SHED
M MOVEABLE BARRIER	-clf-clf-	CHAIN LINK FENCE
CONCRETE JERSEY BARRIER	-Z-Z-	SLIDING GATE
	-bo-bo-	FENCE BY OTHERS
FLAG PERSON	-X-X-	FULL HEIGHT CONCRETE SLAB EDGE PROTECTION (SUPERSTRUCTURE PHASE)
	-X-X-	CABLE GUARDRAIL



200 PARK AVENUE
NEW YORK, NY 10166

THIS PROJECT IS FILED IN COMPLIANCE WITH THE
2014 BUILDING CODE AND IS IN COMPLIANCE WITH
RCNY 3310.01 FACADE RULE

NO.	DATE	REVISION
4	07/06/2018	New Drawing Added to Set
3	02/05/2018	Legend Updated
2	02/01/2018	Note Updated
1	01/22/2018	Key Plan Changed

WEST 66TH STREET

A NEW BUILDING AT
36 West 66th Street

General Information

SEAL & SIGNATURE	DATE: 10/19/16
	PROJECT No.: Author
	DRAWING BY: Checker
	CHECKED BY: Checker
	DWG No. SSP-002.03
SCALE: 3/32" = 1'-0"	CADD FILE No.: PAGE No.: of




**200 PARK AVENUE
NEW YORK, NY 10166**

NOTE:

- * QUANTITY AND LOCATION OF RAMP, GATES, MAN GATES, STORAGE AREAS, TRAILERS, STAIR TOWERS, GENERATORS AND SECURITY BOOTH MAY VARY DUE TO WORK LOGISTICS;
- * TWO MEANS OF EGRESS TO BE MAINTAINED AT ALL TIME. TYPE AND LOCATION TO VARY BASED ON WORK LOGISTICS;
- * S CLEAR ACCESS TO TEMPORARY SIAMESE CONNECTION TO BE MAINTAINED AT ALL TIME;
- * CONSTRUCTION ACTIVITIES ARE NOT TO INTERFERE WITH ACCESS OR USE OF ADJACENT PROPERTIES/DRIVEWAYS;
- * TRAILERS MAY BE DOUBLE STACKED DUE TO WORK LOGISTICS;
- * ALL SIDEWALK TREES IN FRONT OF THE CONSTRUCTION SITE TO BE PROTECTED;

KEY PLAN

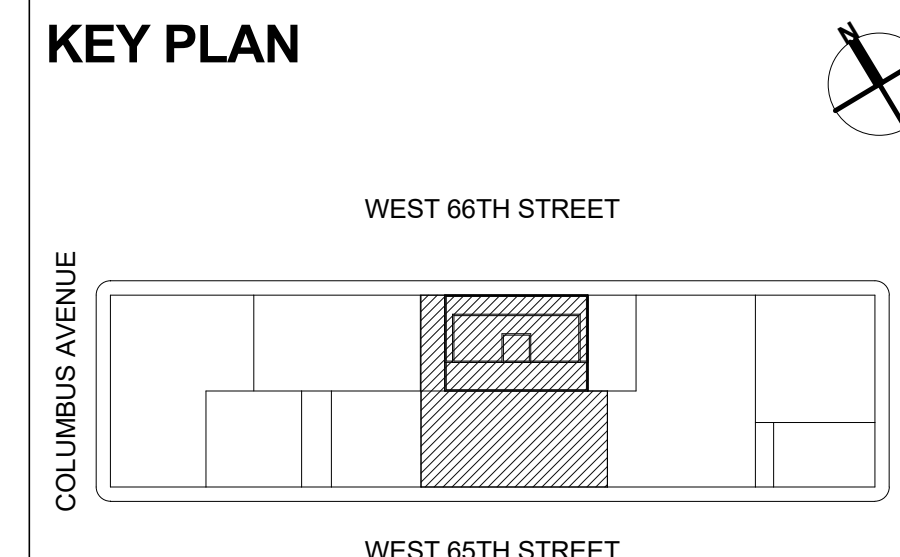

NO.	DATE	REVISION
-----	------	----------

PROJECT

WEST 66TH STREET

A NEW BUILDING AT
36 West 66th Street

Excavation Phase 3.

SEAL & SIGNATURE



SCALE:

$$1/16'' = 1'-0''$$

DATE:	07/06/2018
-------	------------

PROJECT No.:

DRAWING BY: Author

CHECKED BY:	Checker
-------------	---------


CHECKED BY:	CHECKED
DWG No:	


SSD-240 00

	SSP - 240.00
CARD FILE N	PAGE N

CADD FILE No.: PAGE No.:
of

7/30/2018
Z:\10_PERSONNEL\IV_Baranov\Work\36W66 STILOGISTICS\REVIT\36W66 ST 7-27-2018.rvt

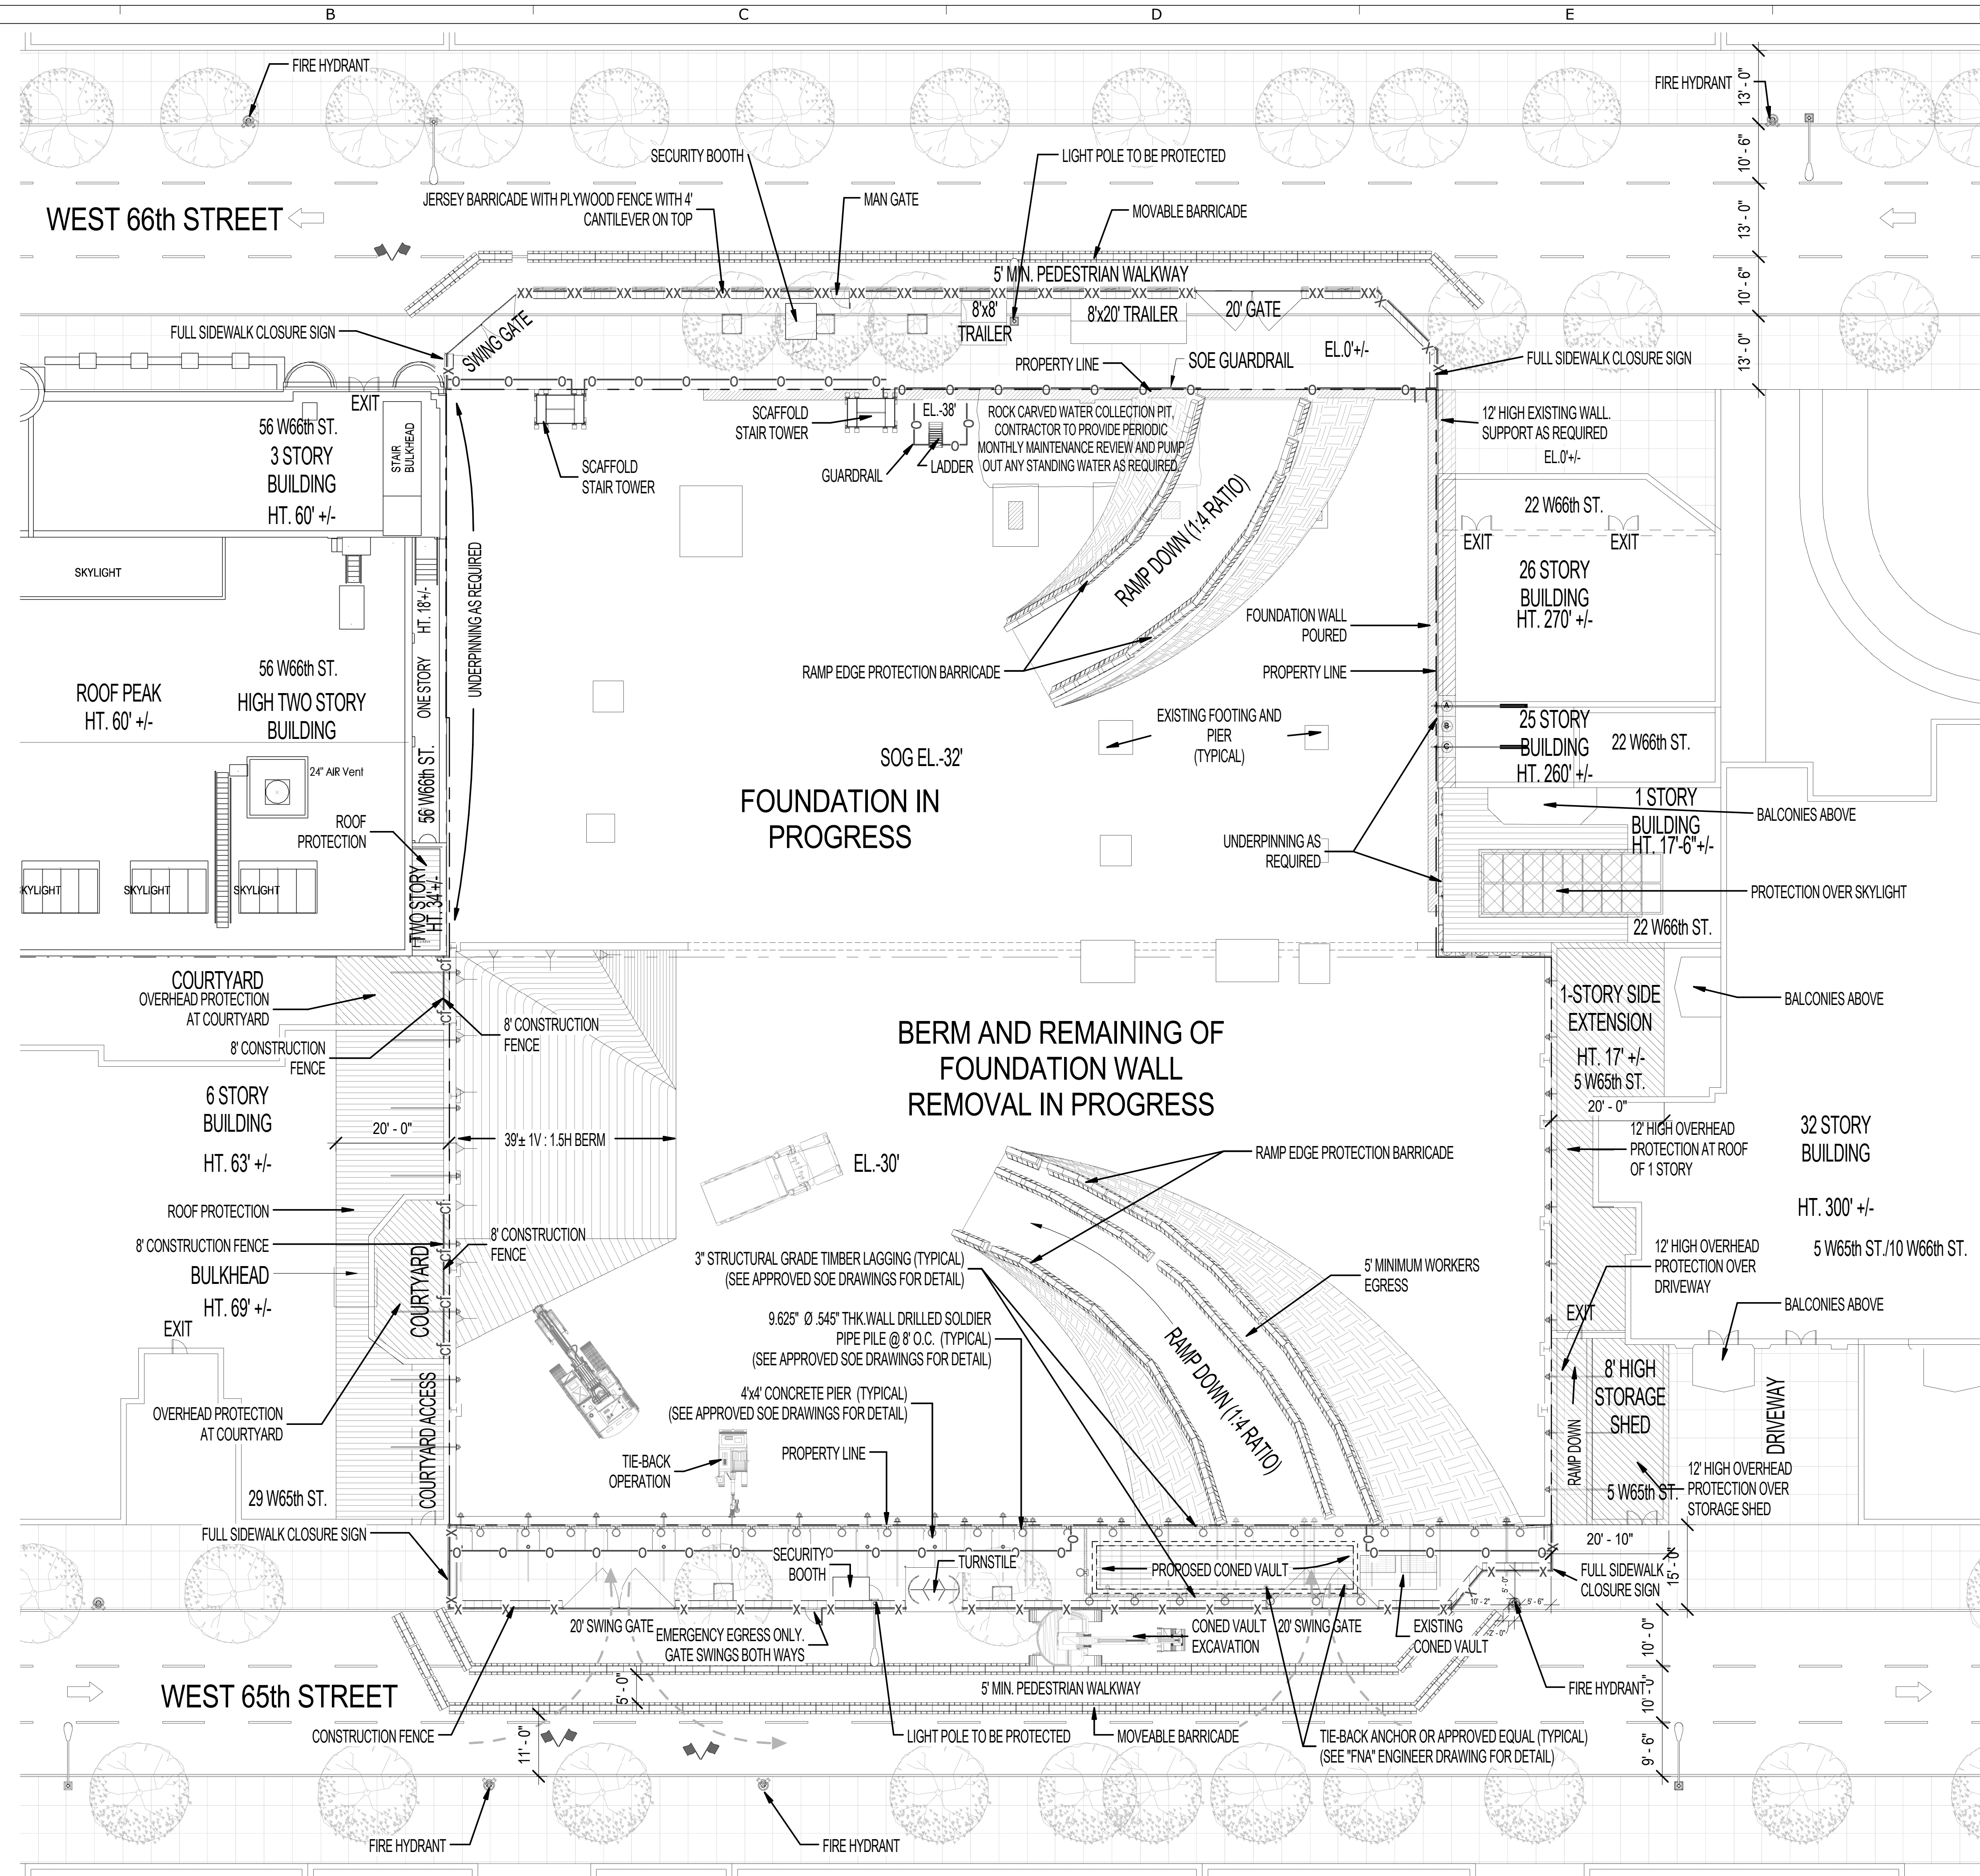
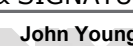
<p>SEAL & SIGNATURE</p> <div style="border: 1px solid black; padding: 10px; text-align: center;"> <p>John Young, RA</p>  <p>APPROVED</p> <p>AMENDED PLAN</p> <p>07/31/2018</p> <p>BEST SSP</p> </div>	<p>DATE: 07/16/18</p> <p>PROJECT No.:</p> <p>DRAWING BY: Author</p> <p>CHECKED BY: Checker</p> <p>DWG No.</p>
<p>SCALE: 1/16" = 1'-0"</p>	<p style="text-align: center; font-size: 2em; font-weight: bold;">SSP-273.00</p> <p>CADD FILE No.: PAGE No.: of</p>

NOTE:

- * QUANTITY AND LOCATION OF RAMP, GATES, MAN GATES, STORAGE AREAS, TRAILERS, STAIR TOWERS, GENERATORS AND SECURITY BOOTH MAY VARY DUE TO WORK LOGISTICS;
- * TWO MEANS OF EGRESS TO BE MAINTAINED AT ALL TIME. TYPE AND LOCATION TO VARY BASED ON WORK LOGISTICS;
- * 5' CLEAR ACCESS TO TEMPORARY SIAMESE CONNECTION TO BE MAINTAINED AT ALL TIME;
- * CONSTRUCTION ACTIVITIES ARE NOT TO INTERFERE WITH ACCESS OR USE OF ADJACENT PROPERTIES/DRIVEWAYS;
- * TRAILERS MAY BE DOUBLE STACKED DUE TO WORK LOGISTICS;
- * ALL SIDEWALK TREES IN FRONT OF THE CONSTRUCTION SITE TO BE PROTECTED;

NO.	DATE	REVISION
-----	------	----------

PROJECT

WEST 66TH STREET

A NEW BUILDING AT
36 West 66th Street

Foundation Phase

SEAL & SIGNATURE

John Young, RA
John Young
APPROVED
AMENDED PLAN
07/31/2018
BEST S

SCALE:

$$1/16'' = 1'-0''$$

DATE:	07/06/201
-------	-----------

PROJECT No.:

DRAWING BY:

CHECKED BY:

CHECKED BY:
DWG No.

SSD-335 00

SSP - 555.00	
CARD FILE N	PAGE N

CADD FILE No.: PAGE No.:
of

