


AS-BUILT MAR 23 1982



No.	Item	Date	By	Approved	Date

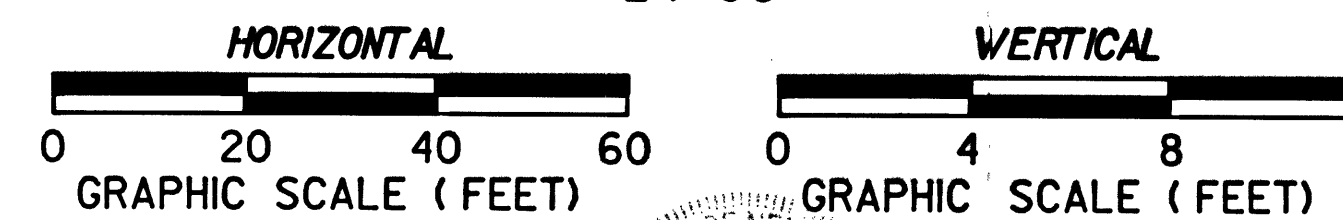

**Office of the Chief Engineer**  
National Railroad Passenger Corporation, 30th Street Station, Philadelphia, PA 19104

DESIGNED: V.M.  
DRAWN: R.L.B.  
CHECKED: S.Y.  
IN CHARGE: A.G.  
DATE: 7/31/87



**Parsons Brinckerhoff Quade & Douglas, Inc.**  
New York, New York

Engineers  
Planners

NORTH ACCESS TUNNEL WEST 33RD. STREET TO WEST 38TH. STREET	
PROFILE STA. 20+00.00 TO STA. 26+00.00	Project No. E-8715 Drawing No. C-16 Sheet No. 016