
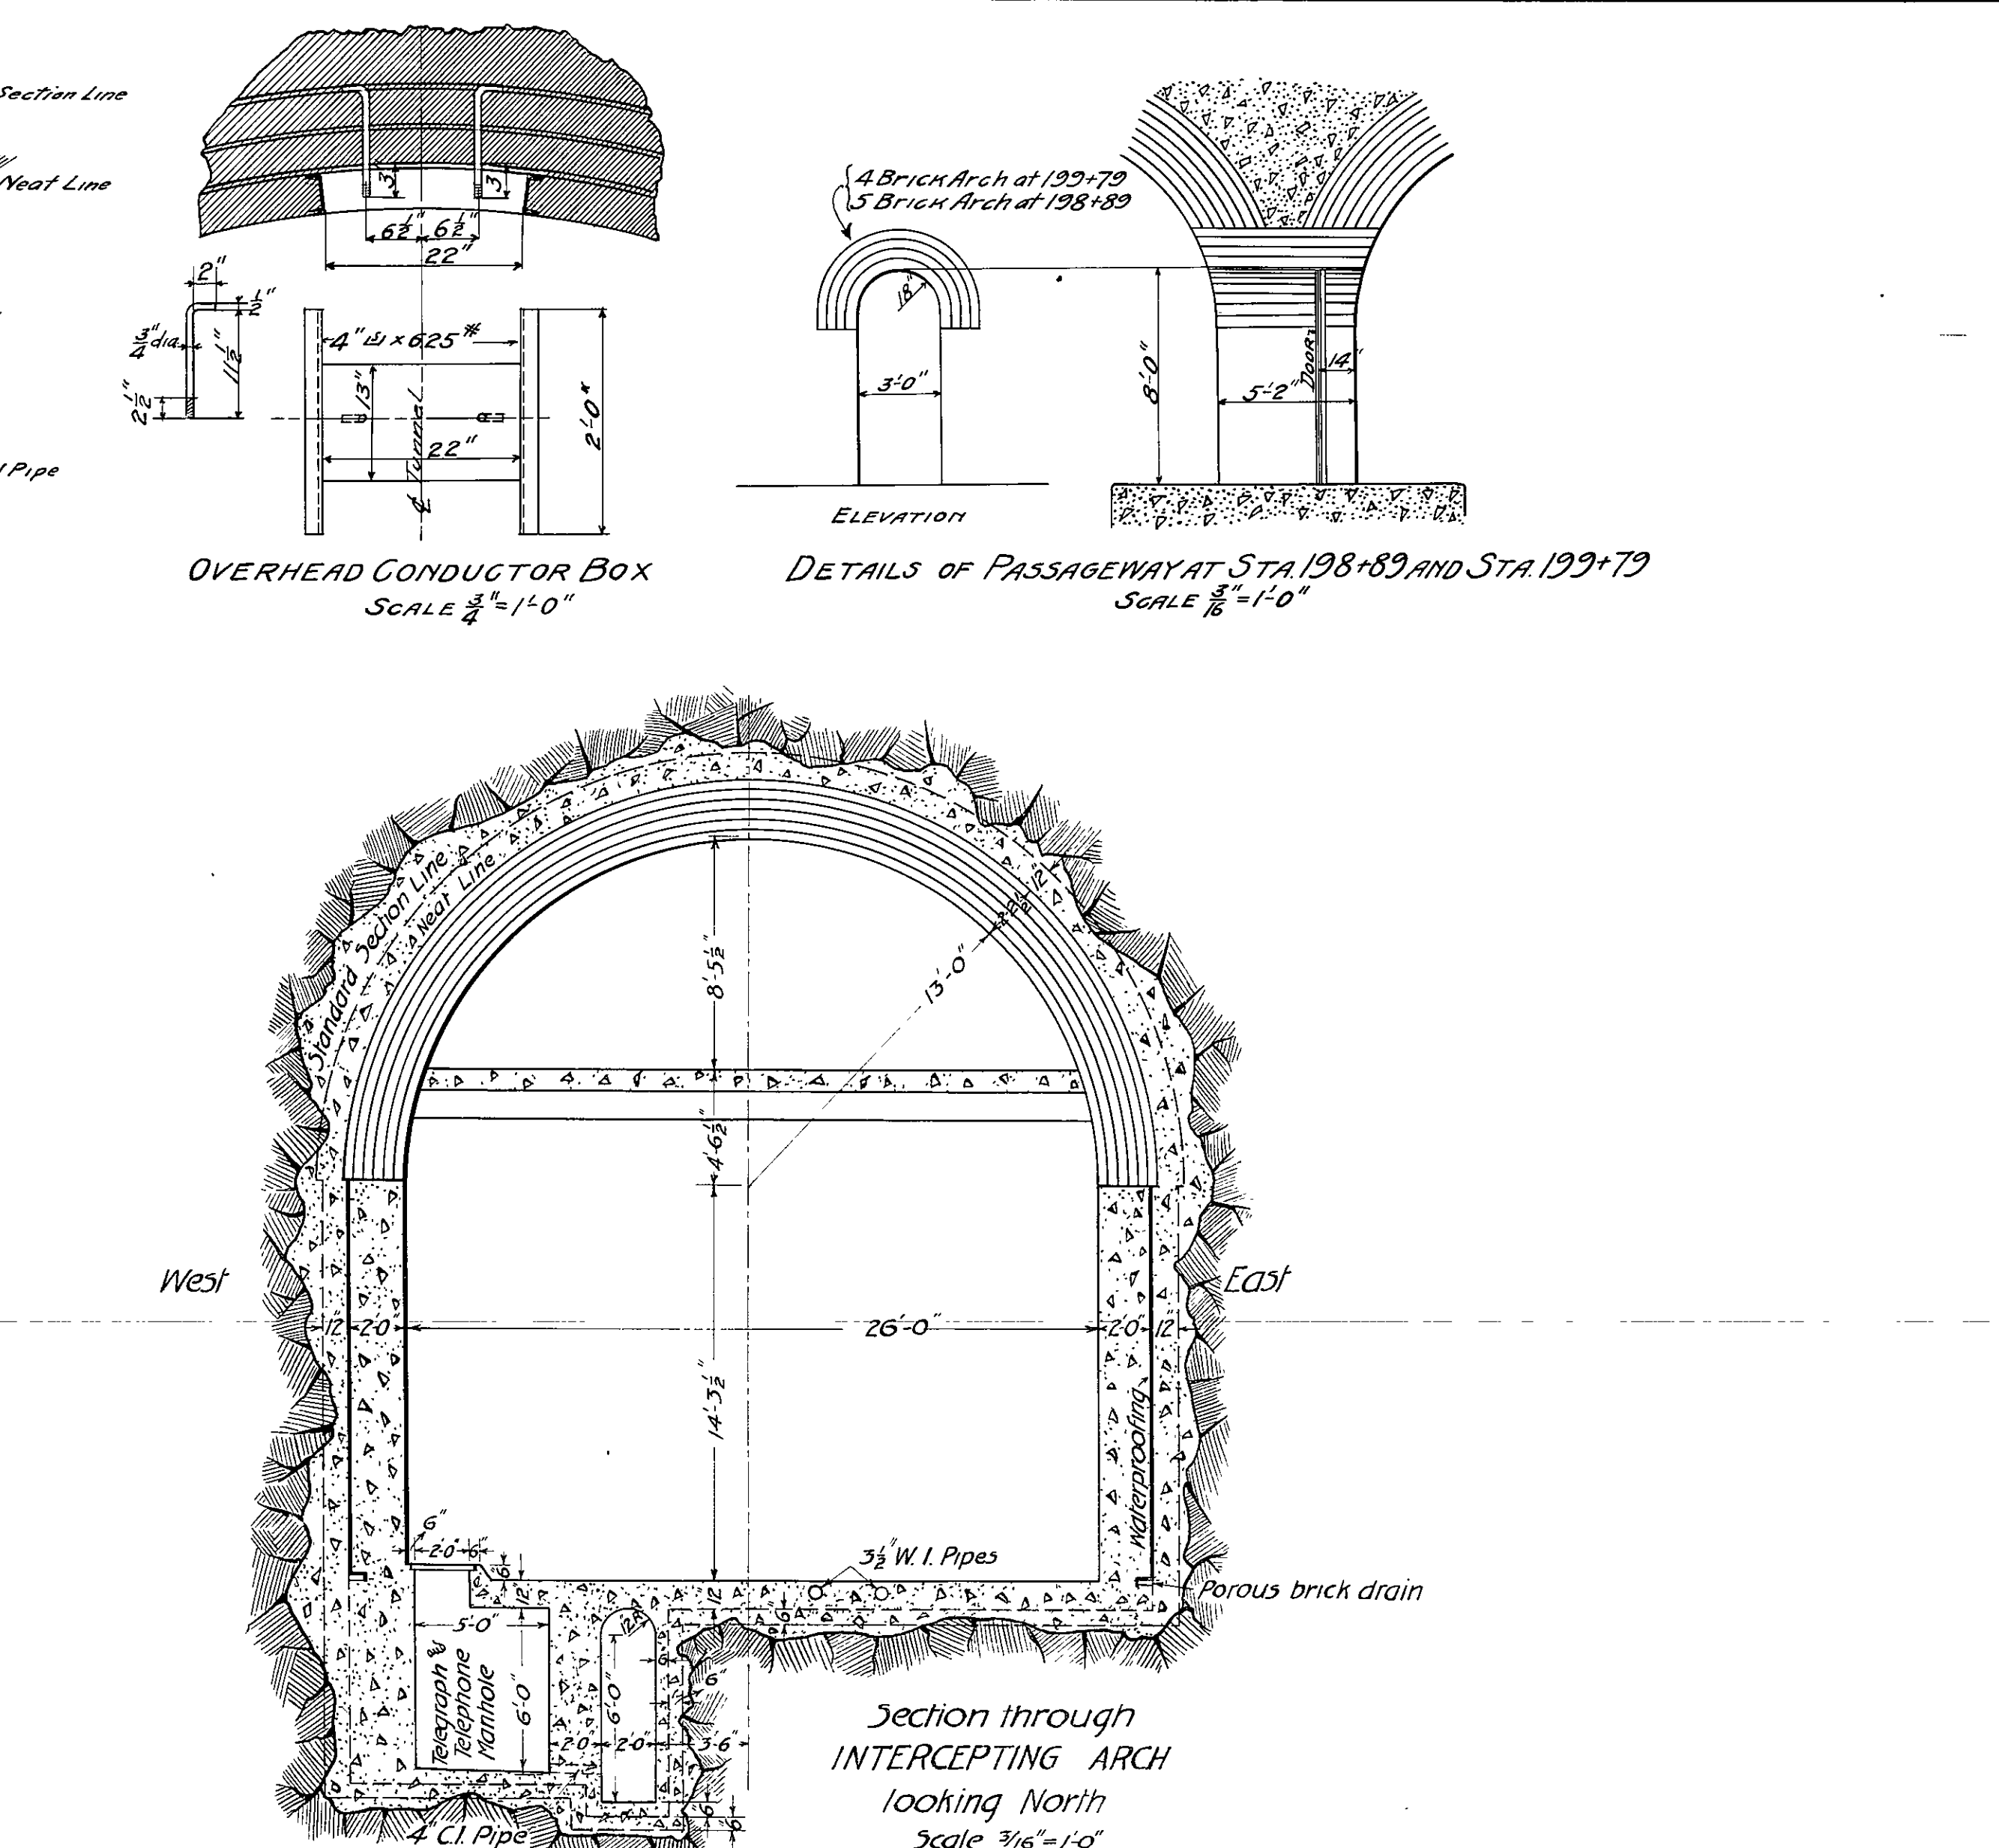


In order to obtain a bond between the different courses of brickwork, whenever a continuous joint was obtained through all courses, a double row of headers was put in. In order to have this uniform the exact location of these joints was pre-determined by calculation

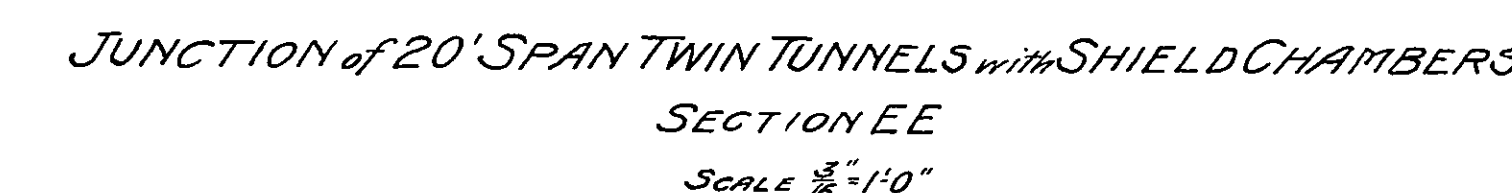

32ND STREET TUNNELS

GENERAL PLAN & SECTIONS

Shield Chambers to Shaft
inclusive

Drawing No. E 1287

Superseding Contract Drawing No. 610 E
Scales as indicated April 1903

Charles M. Sachs Jr.

Plan of Work as Constructed