

Summary of Comments on sw tower PAA #4

2017-04-10.pdf


Page: 1

Author: dtitus Subject: Rectangle Date: 7/6/2017 4:02:52 PM
security should be identify on the schedule "A" as use group 6, Occupancy??

Author: dtitus Subject: Rectangle Date: 7/6/2017 3:56:02 PM
~~PW 1 item 12 Zoning Characteristics requires amending~~

no parking provided
under this application

open

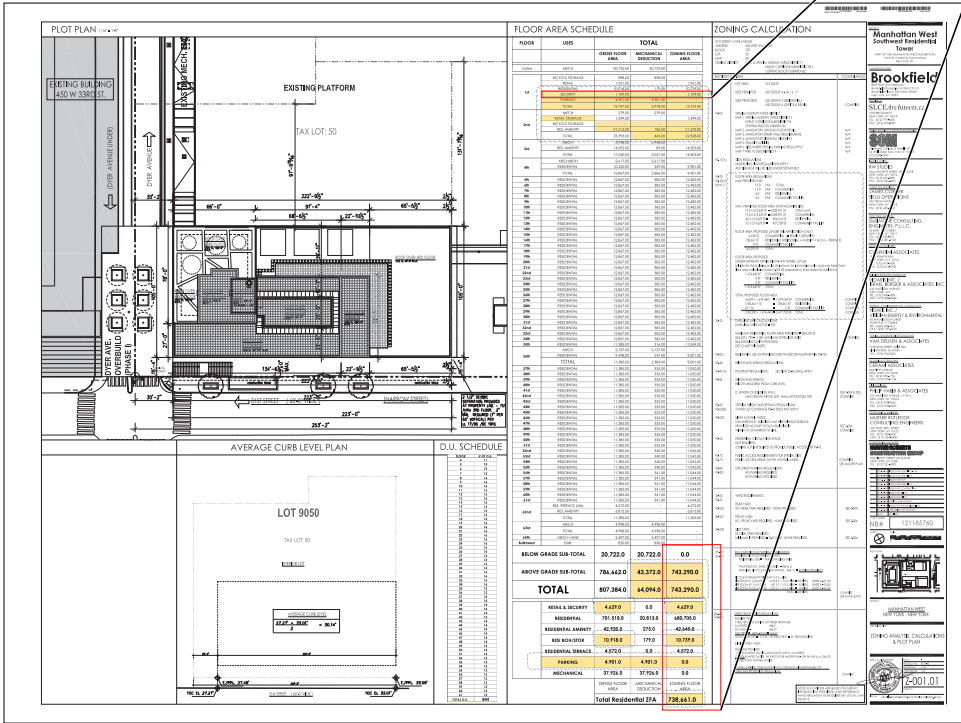

☐ Author: dtitus Subject: Rectangle Date: 7/1/2011
Please clarify, security within residential use??

08-08-17

~~What/where is sally port area????~~

