



CONTRACTOR:
NEW YORK CONCRETE CORP.
708 SHARROTT'S ROAD
STATEN ISLAND, NY 10309
o: 718 967 3720

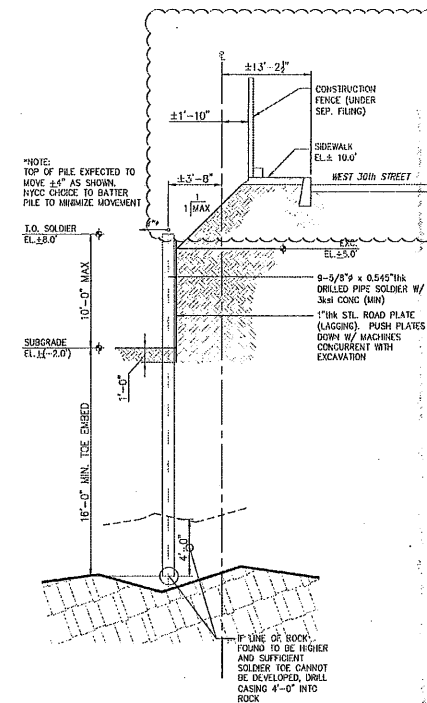


1 PARTIAL SOE PLAN, STORMWATER TANK
120 SCALE: 3/16" = 1'-0"

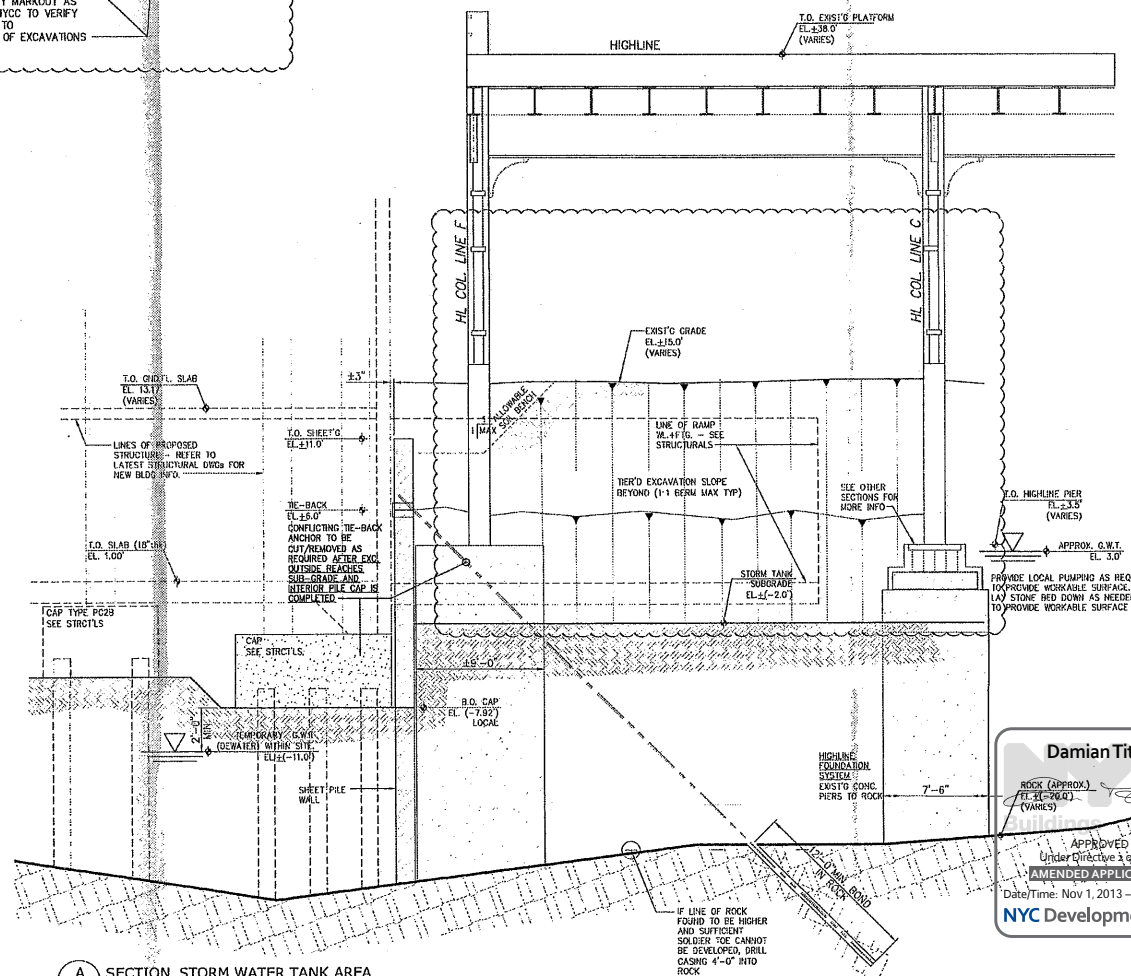


SECTION STORM WATER TANK AREA
SCALE: 1/4" = 1'-0"


AS-BUILT-DOB Comment	10-22-13
AS-BUILT	10-14-13
AS-BUILT	10-12-13
AS-BUILT	10-08-13
AS-BUILT	10-02-13
NEW SHEET	08-24-13
UPDATE ISSUE	12-03-12
1 SOE V.E.	11-12-12
N ^o Revision:	Date:

N	SCALE:
	AS NOTED

KEY PLANS

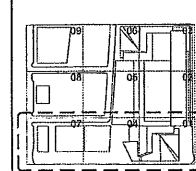


DRAWING TITLE:
STORMWATER
TANK AREA

 


SEAL	Date
	11-02-12
	PROJECT N°:
	12037
	Drawn By:
	GM/NA
	DWG. N°:
	S0E-120.01

AS BUILT


FNA
FACILITY MANAGEMENT ASSOCIATION
100 WEST 30TH ST, 10TH FLOOR
NEW YORK, NY 10014
CONTRACTOR:
NEW YORK CONCRETE CORP.
708 SHARROTT'S ROAD
STATEN ISLAND, NY 10319
P: 718.997.3770

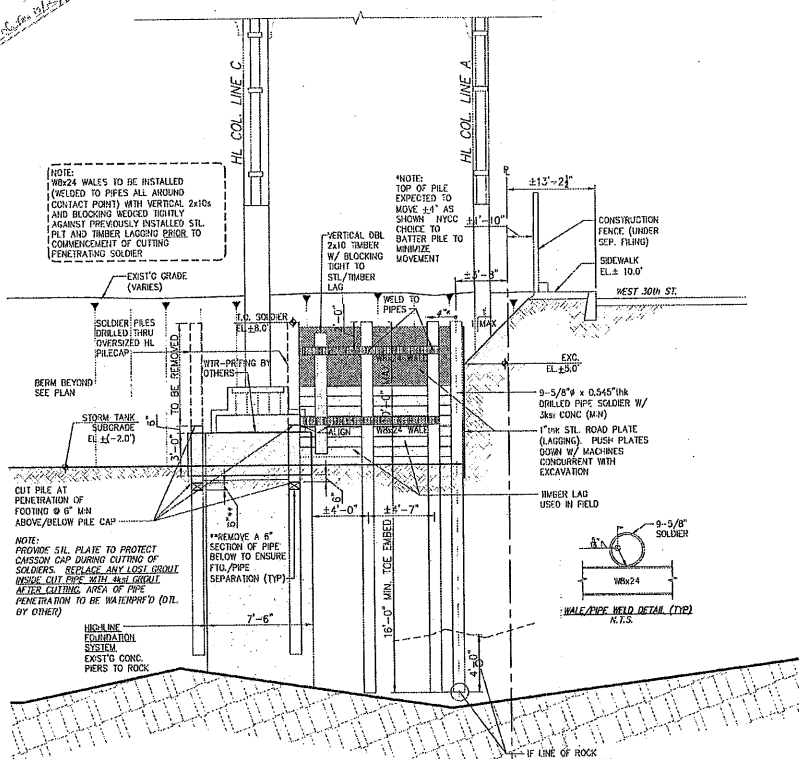

C SECTION STORM WATER TANK AREA
SCALE: 1/4" = 1'-0"

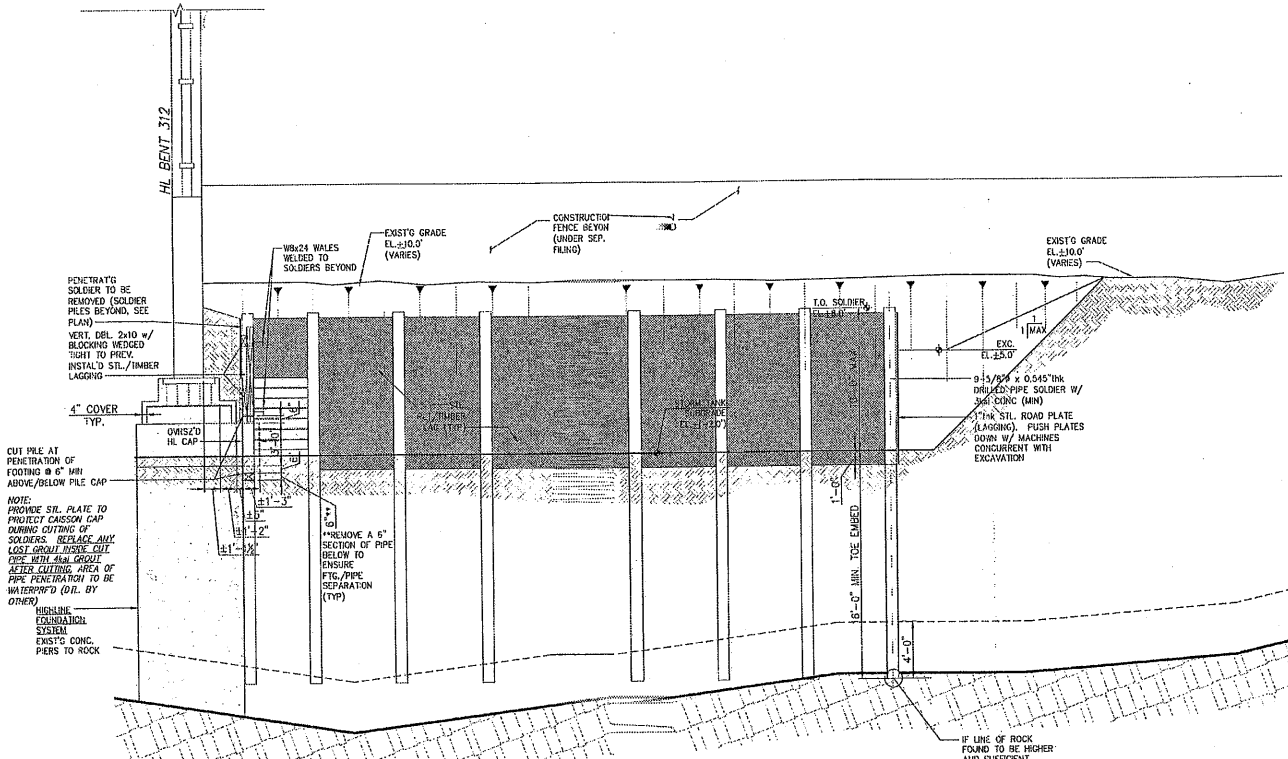

D SECTION STORM WATER TANK AREA
SCALE: 1/4" = 1'-0"

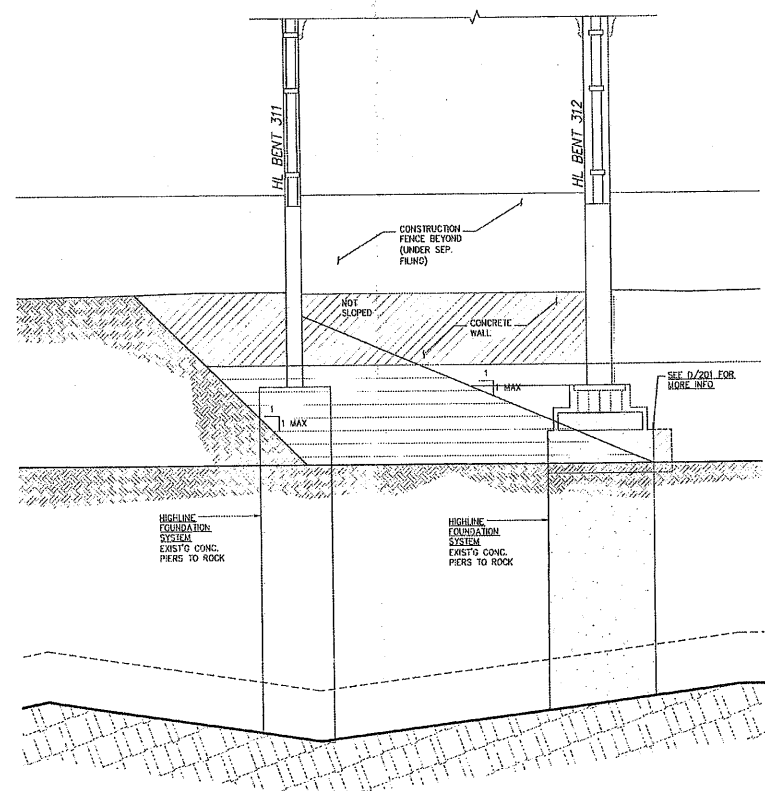


E SECTION STORM WATER TANK AREA
SCALE: 1/4" = 1'-0"

HUDSON YARDS - TOWER C
501 WEST 30th ST.
NEW YORK | NEW YORK

NEW SHEET/AS-BUILT	10-22-13
UPDATE ISSUE	12-03-12
SOC V.E.	11-12-12
N Revision	Date

SCALE:
AS NOTED

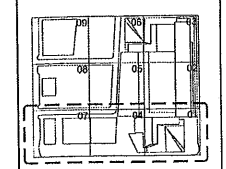

DRAWING TITLE:
**STORMWATER
TANK AREA**
SEAL
Date: 11-02-12
PROJECT N°: 12037
Drawn By: GMINA
DWG. N°:
SOF-121.00

Damian Titus
Buildings
APPROVED
Under Directive 2 of 1975
AMENDED APPLICATION
Date/Time: Nov 1, 2013 - 1:43 PM
NYC Development Hub

NEW SHEET